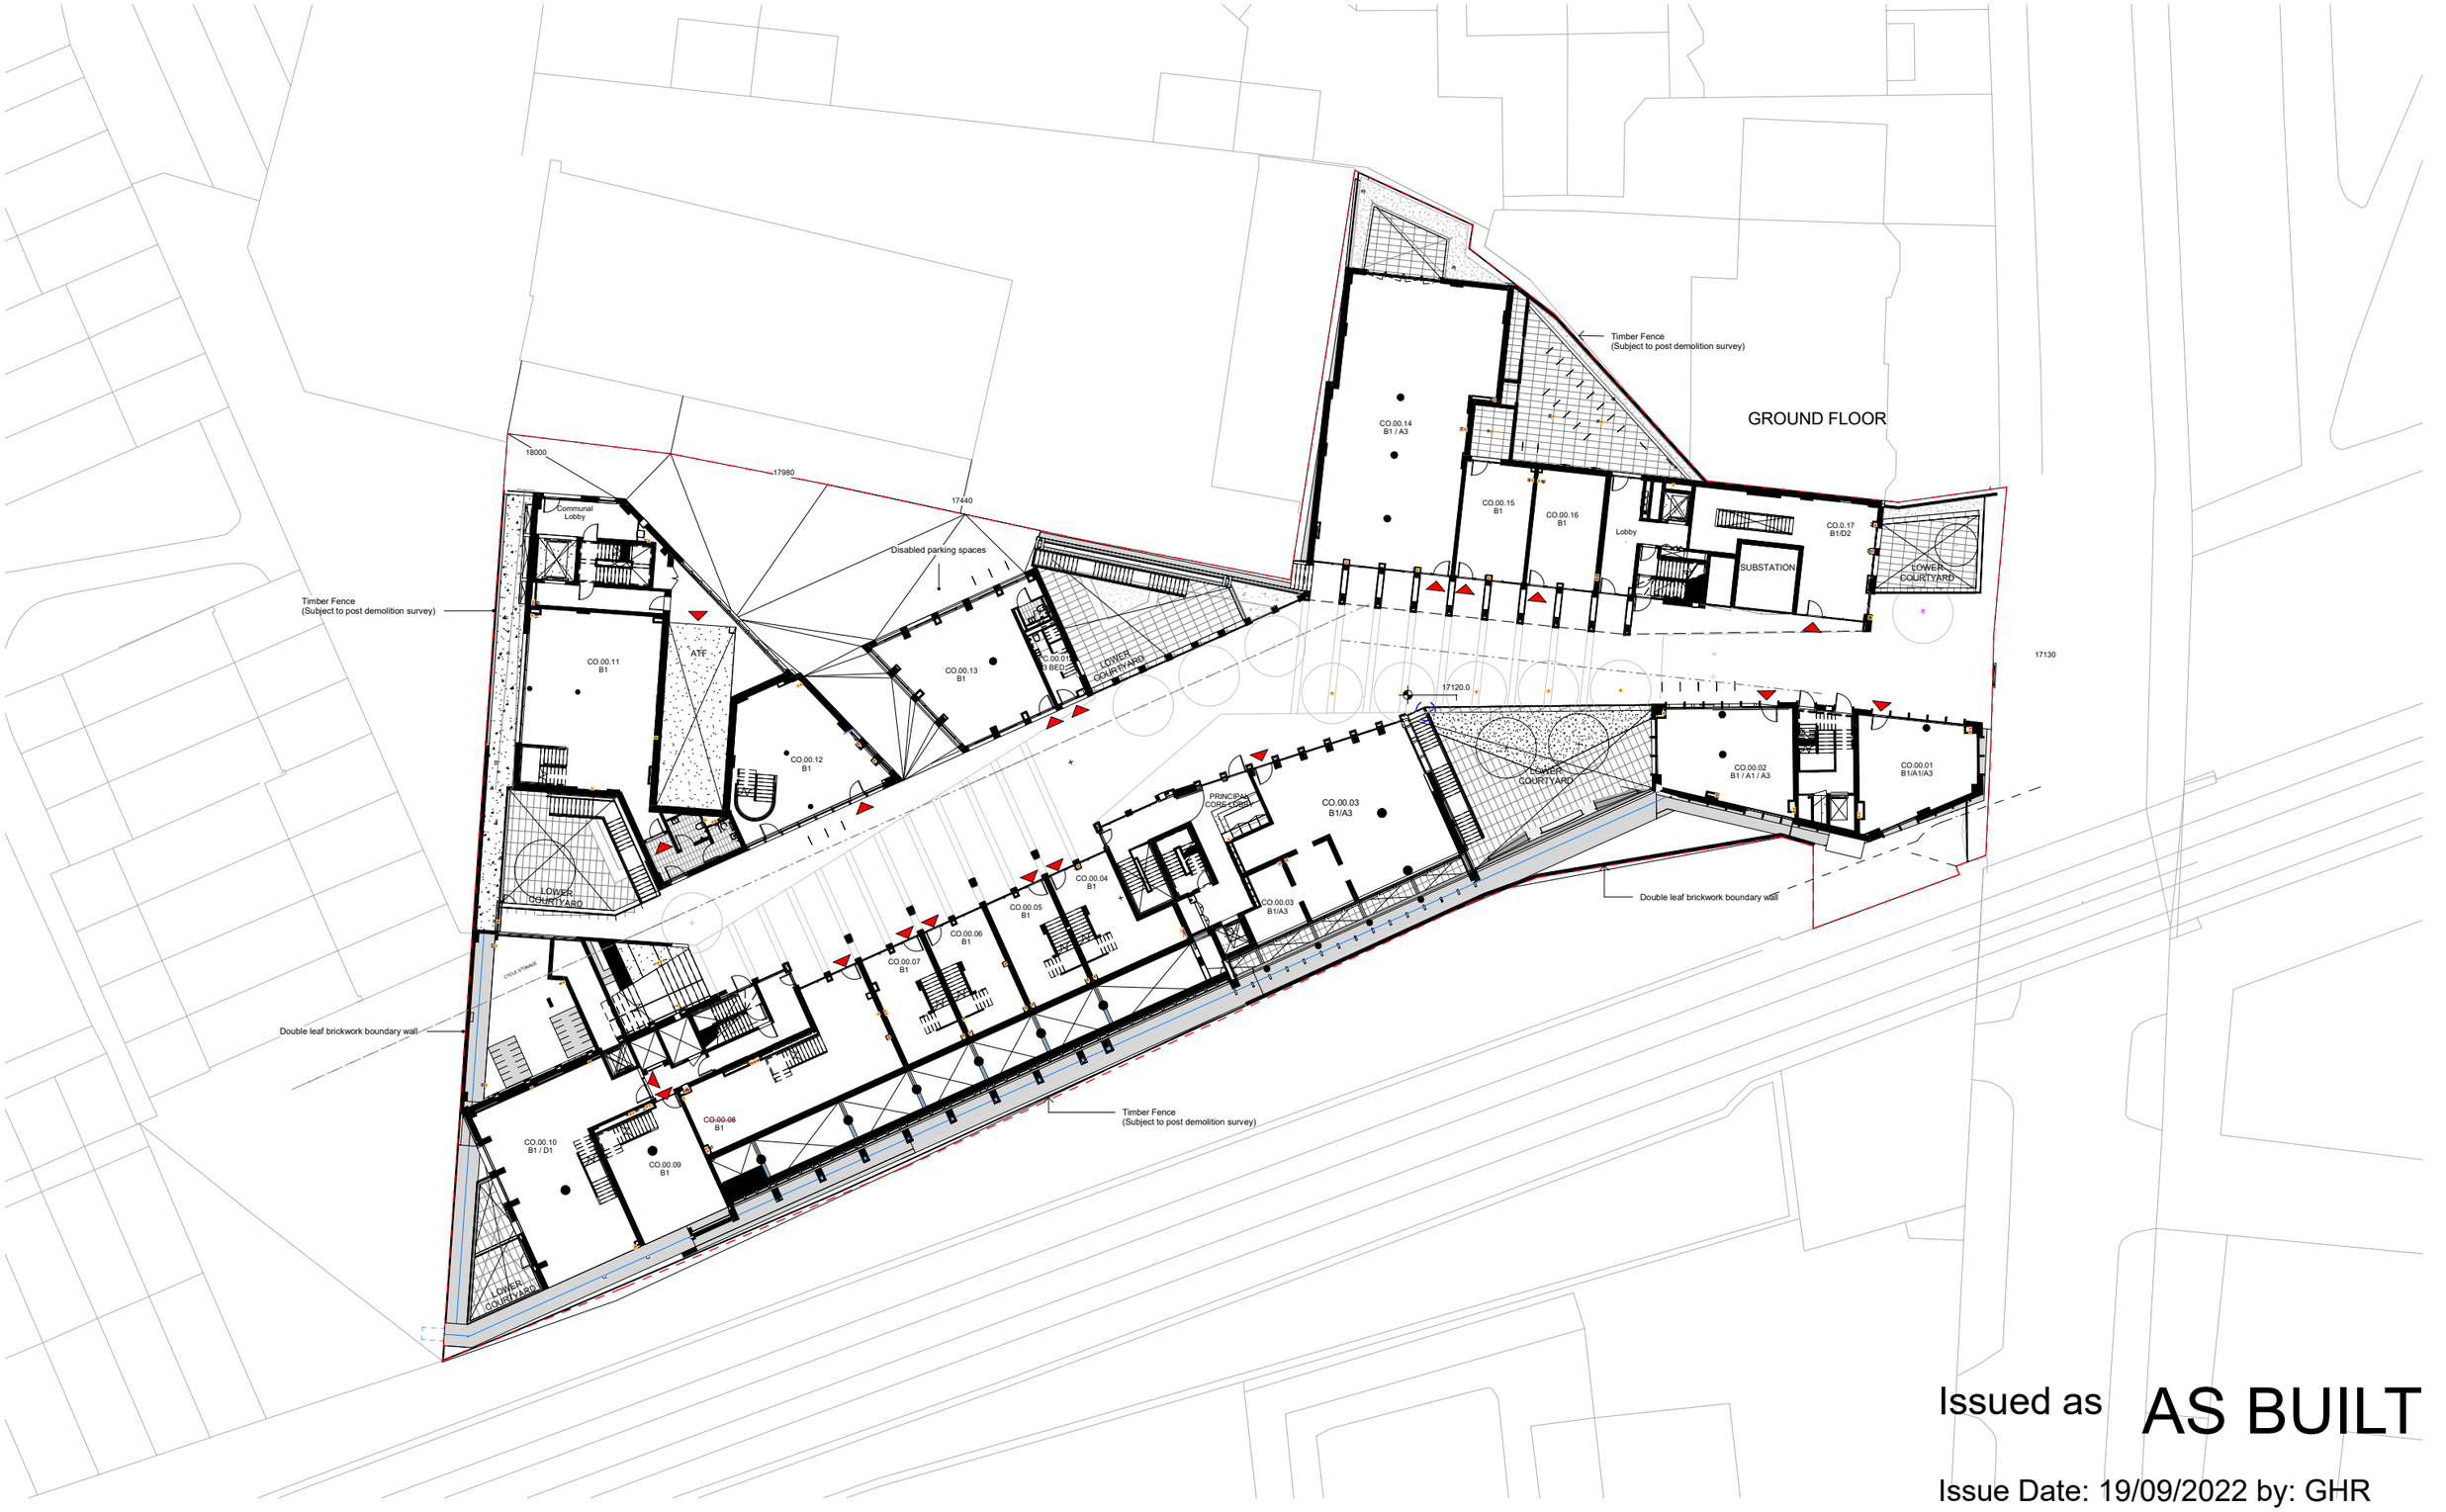



Issued as **AS BUILT**

Issue Date: 19/09/2022 by: GHR

| REV. | DESCRIPTION | DATE | BY |
|---|---|---|---|
| C 1 | ISSUED FOR CONSTRUCTION | 15.04.2019 | PG |
| C 2 | ISSUED FOR INFORMATION | 29.11.2019 | PG |
| C 3 | STREET NAMING & NUMBERING APPLICATION | 30.04.2020 | PG |

30/04/2020 9:49:19

NOTES

DO NOT SCALE FROM THIS DRAWING

The contractor shall check and verify all dimensions on site and report any discrepancies in writing to Studioanyo before proceeding work.

All dimensions based on drawing information received from client, Client or appointed Contractor to carry out site dimension checks or surveys initially prior to tender and again prior to construction or manufacture.

PROJECT No: **0026**

DRAWN **PG** CHECKED **KS**

DATE **30.04.2020**

STATUS **Construction**

**1 : 200** SCALE@A1

0 1 5 10 M

CLIENT
**Downs Road Development LLP**

PROJECT TITLE
**DOWNS RD - DOCUMENTATION**

DRAWING NAME
**Site Plan - Ground Floor**

DRAWING NO.
**0026-ALS-XX-00-DR-A-1101- C3**

Studio 21, Monohaus | 143 Mare Street | London | E8 3FW
www.studioanyo.com | +44(0)20 8016 8665

The copyright in this drawing is vested in Studioanyo and no license or assignment of any kind has been, or is, granted to any third party whether by provision of copies or originals or otherwise unless agreed in writing.
© COPYRIGHT